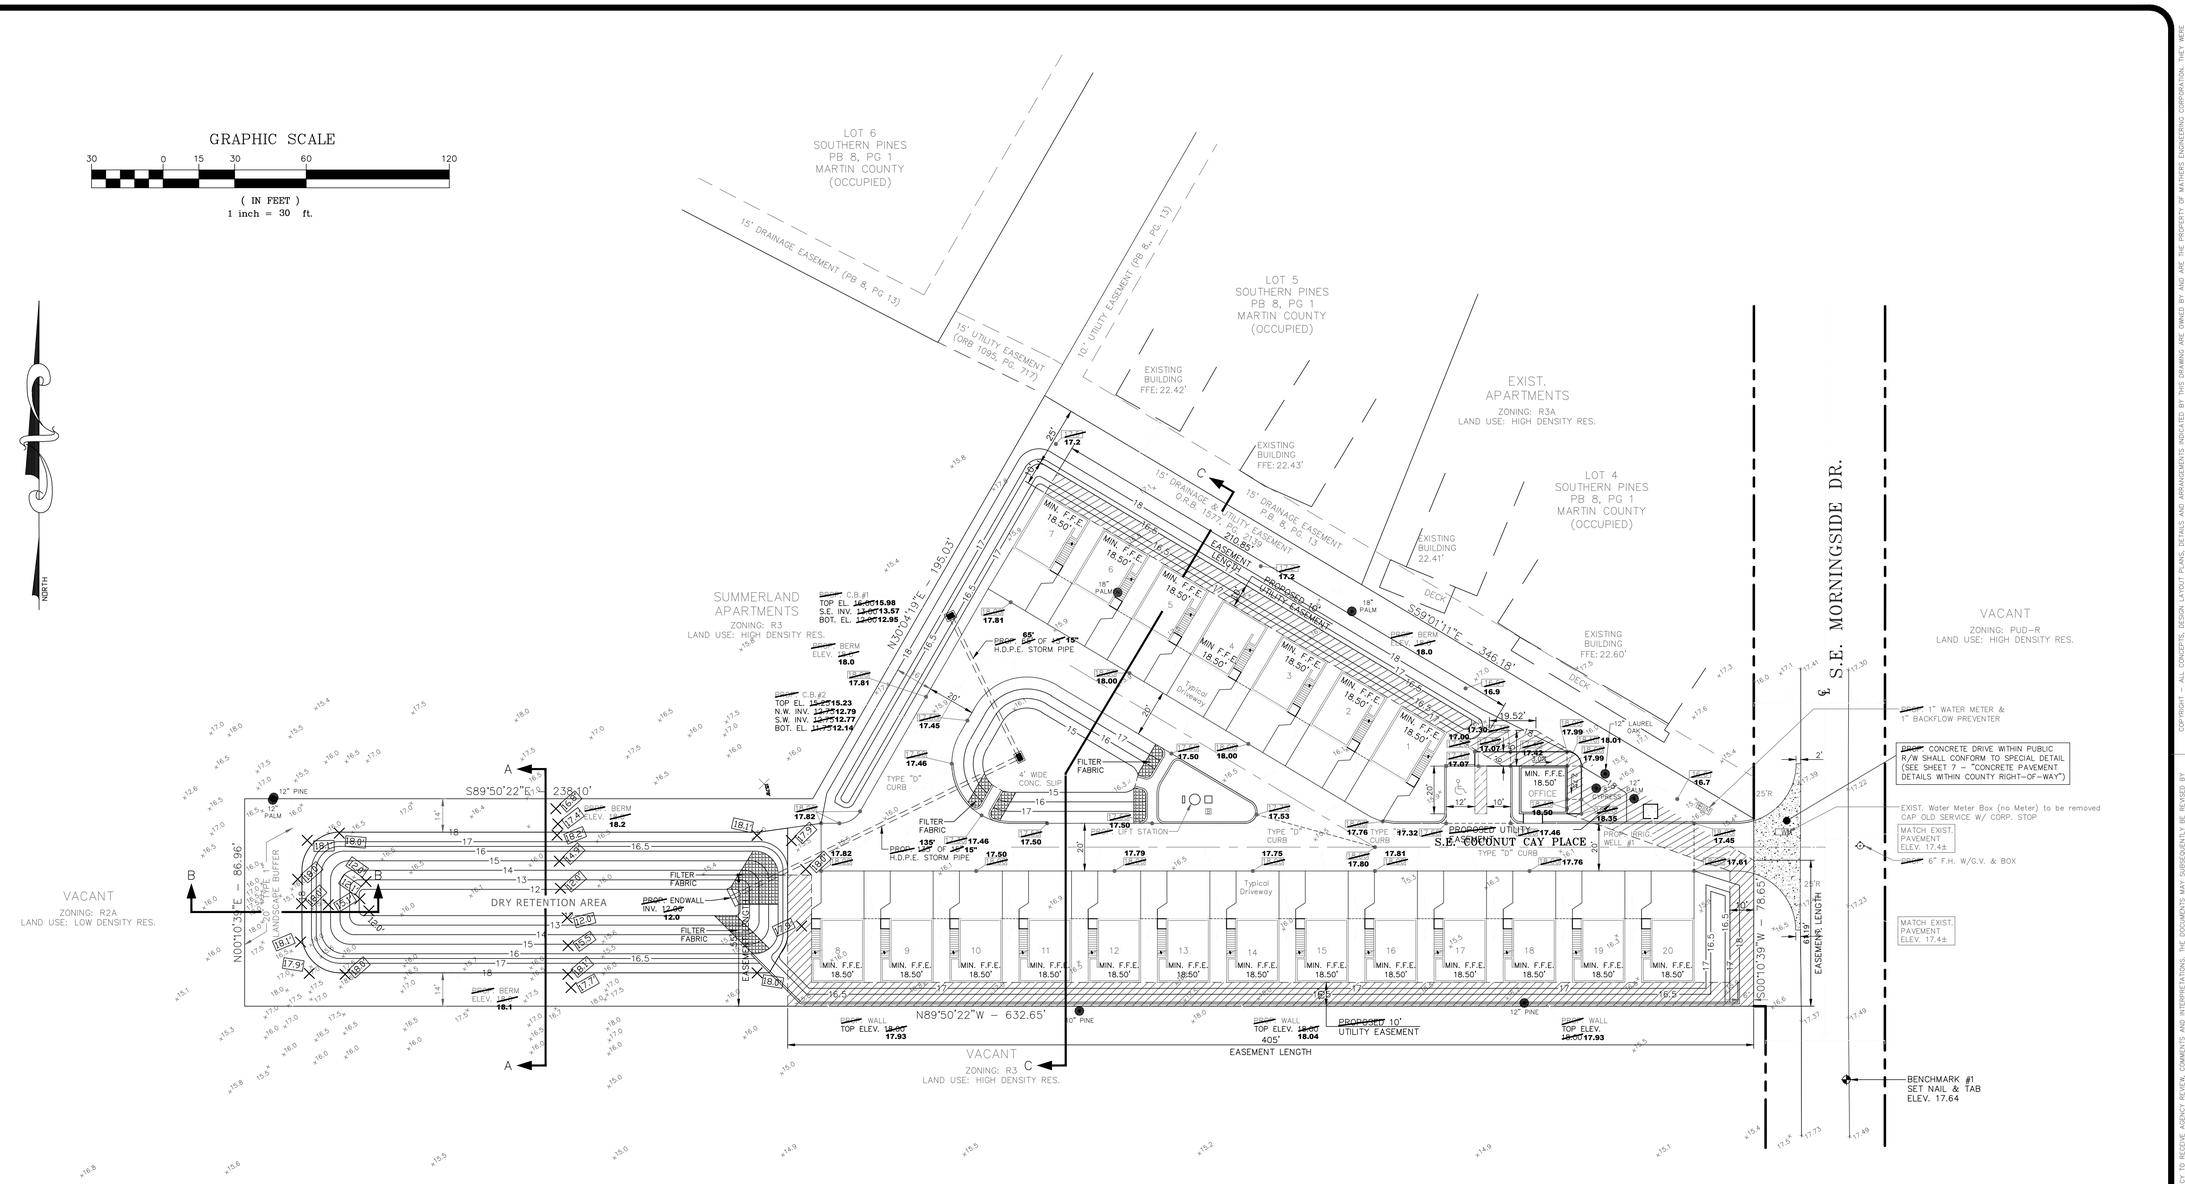

I, MICHAEL T. OWEN, DO HEREBY CERTIFY THAT THE PAVING, GRADING & DRAINAGE AS-BUILTS SHOWN HEREON ARE BASED ON THE ENGINEERS DESIGN CAD FILE FOR THE CONSTRUCTION PLANS AND ARE TRUE AND CORRECT TO THE BEST OF MY KNOWLEDGE AND BELIEF, AS OF JULY 12, 2024, BEING THE LAST DATE OF FIELD WORK. ELEVATIONS ARE BASED ON THE DESIGN ENGINEERS PLANS AND ARE RELATIVE TO THE NORTH AMERICAN VERTICAL DATUM OF 1988 (NAVD'88). ALL DATA SHOWN ARE IN U.S. FEET. THE AS-BUILT DATA **SHOWN IN THIS TYPE OF TEXT** CONSISTS OF THE FOLLOWING: PAVING, GRADING & DRAINAGE AND APPURTENANCES FOR THE PROJECT IN QUESTION. THIS IS NOT A BOUNDARY SURVEY.

MICHAEL T. OWEN — SIGNATURE DATE
PROFESSIONAL SURVEYOR AND MAPPER
FLORIDA REGISTRATION NUMBER 5556

AS-BUILT NOTES AND REPORT:

1) THIS IS NOT A BOUNDARY SURVEY.
2) THIS IS AN AS-BUILT SURVEY FOR PAVING, GRADING & DRAINAGE.
3) REPRODUCTIONS OF THIS MAP ARE NOT VALID WITHOUT THE SIGNATURE AND ORIGINAL RAISED SEAL OF A FLORIDA LICENSED SURVEYOR AND MAPPER. THIS SURVEY CANNOT BE TRANSFERRED OR ASSIGNED WITHOUT THE SPECIFIC WRITTEN PERMISSION OF ENGINEERING, DESIGN, AND CONSTRUCTION, INC. IT IS A VIOLATION OF CHAPTER 5J-17, FLORIDA ADMINISTRATIVE CODE, TO ALTER THIS SURVEY WITHOUT THE EXPRESS PRIOR WRITTEN CONSENT OF THE SURVEYOR. ADDITIONS AND/OR DELETIONS MADE TO THE FACE OF THESE AS-BUILTS WILL MAKE THEM NULL AND VOID.
4) THE VERTICAL DATUM AND ELEVATIONS SHOWN HEREON ARE BASED ON THESE APPROVED CONSTRUCTION PLANS, AS PREPARED BY THE ENGINEER. THE HORIZONTAL LOCATIONS ARE BASED ON FLORIDA STATE PLANE COORDINATES, FLORIDA NAD83 STATE PLANE EAST ZONE, AND ARE IN FEET AND DECIMAL PARTS THEREOF.

EDC PROJECT # 19-382

5		
4		
3		
2		
1		
REVISIONS		

DRAWN BY: CPS FIELD CREW: SV

A DIVISION OF HALEY WARD, INC.
F.B.P.E. AUTHORIZATION No. 32664
L.B. AUTHORIZATION NO. 8267
10250 Village Parkway, Suite 201
Port Saint Lucie, Florida 34987
772.462.2455
WWW.HALEYWARD.COM

F.B.P.E. CERTIFICATE OF AUTHORIZATION 32664
L.B. CERTIFICATE OF AUTHORIZATION 8267

AS-BUILT LEGEND:

LF	LINEAR FEET
N/A	INFORMATION NOT AVAILABLE
	UNDERGROUND STORM
~~00.00~~ **00.00**	ASBUILT DATA
× 0.0	ASBUILT ELEVATIONS

DATE	REVISIONS
10.21.21	REV PER COUNTY COMMENTS
2.07.22	REV PER COUNTY COMMENTS
7.12.22	1 REVISE ENTRANCE

PHONE: (772) 287-0525
EB 0004466
2431 SE DIXIE HIGHWAY
STUART, FL 34996
MATHERS ENGINEERING CORPORATION
CIVIL
STRUCTURAL
CONSULTING

Cottages at Coconut Cay
MARTIN COUNTY, FLORIDA
PAVING & GRADING PLAN

WILLIAM J. MATHERS, P.E.
FL. REG. #19658

DRAWN	D.H.A.
CHECKED	W.J.M.
DATE	MAY 2021
SCALE	1" = 30'
JOB NO.	3818-01
SHEET	3 OF 12 SHEETS

COPYRIGHT – ALL CONCEPTS, DESIGN, LAYOUT, PLANS, DETAILS, AND INFORMATION CONTAINED BY THIS DRAWING ARE OWNED BY AND ARE THE PROPERTY OF MATHERS ENGINEERING CORPORATION. THEY WERE CREATED AS INSTRUMENTS OF SERVICE FOR THE SPECIFIC PROJECT AND SHALL NOT BE USED OR REPRODUCED WITHOUT THE EXPRESSED WRITTEN PERMISSION OF MATHERS ENGINEERING CORPORATION.

